



818 S. FLORES ST. ① SAN ANTONIO, TEXAS 78204 ① www.saha.org

Procurement Department

ADDENDUM #3

To: RFQ# 1111-909-62-3654
RFQ for Repairs at 1004 Alametos
Date: December 13, 2011


Question 1: My estimator needs measurements for the countertop Formica repair, the damaged sheetrock that was abated for mold and for the new insulations where it was removed for abatement. He also needed measurements for the size of the water damage penetration or leak above the master closet that needs repair. We need not find any of this information in the inspection report.

Answer 1: The Formica repair is an end cap on one side of the counter, about two feet long. Approximately 525 sqft of mold impacted drywall was removed. Attached is a drawing which redlines what was removed. As for the water leak above the master closet, we are not sure where it is coming from. There is no obvious location, but there was a water stain on the ceiling where the master closet sheetrock was removed.

Drawing is attached.

By: Carl Bottoms
Procurement Supervisor

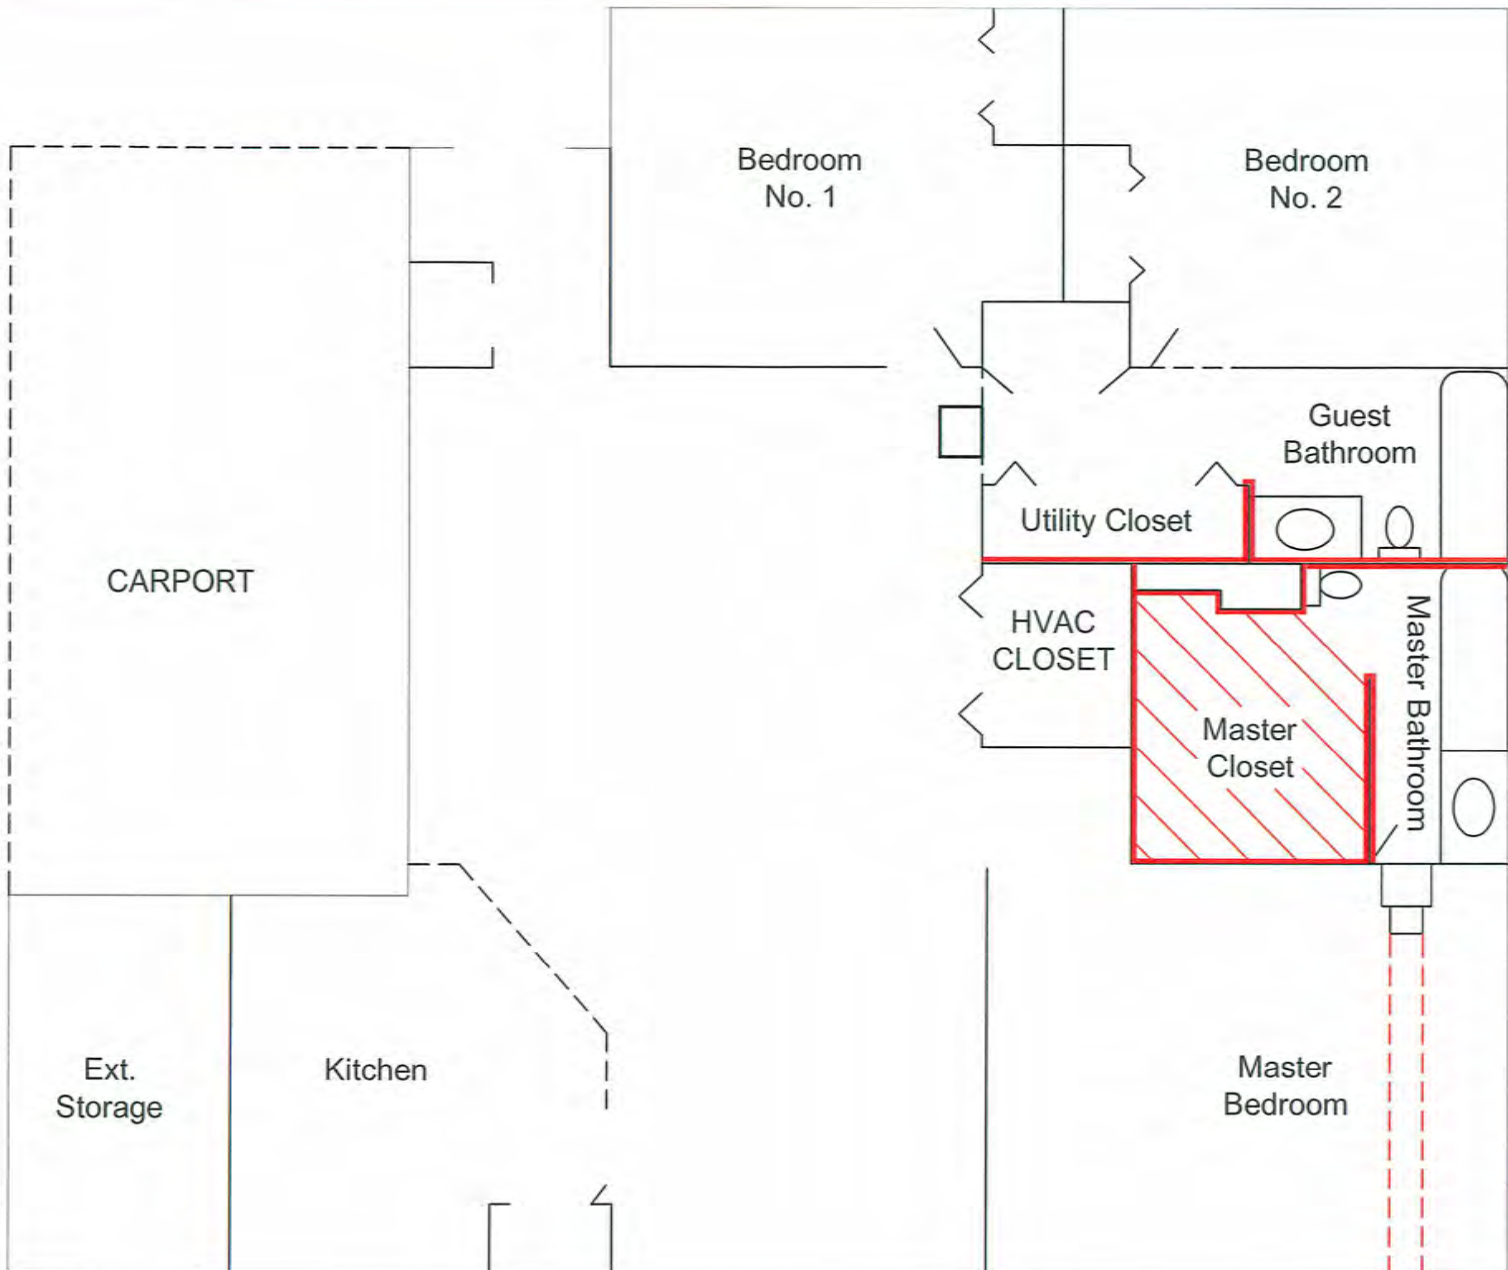


Date: December 13, 2011




Will C. Deveau

WILL C. DEVEAU
 MOLD ASSESSMENT CONSULTANT
 TDSHS LICENSE NO. MAC 1173
 EXPIRES 09/16/2012

LEGEND:

-  -STRIP, REMOVE, AND DISPOSE OF MOISTURE / FUNGAL IMPACTED DRYWALL CONSTRUCTION
-  -POTENTIAL LOCATION TO ESTABLISH 1 - STAGE DECONTAMINATION CHAMBER
-  -POTENTIAL LOCATION TO VENT HFU TO BUILDING EXTERIOR



Project Mngr:	WCD	Project No:	90117286
Drawn By:	LS(90)	Scale:	N.T.S.
Checked By:	WCD	File No:	90117286
Approved By:	WCD	Date:	09/2/11

Terracon
 Consulting Engineers and Scientists

6911 BLANCO ROAD SAN ANTONIO, TX 78216
 PH. (210) 641-2112 FAX. (210) 641-2124

MOLD LOCATION DRAWING

1004 Alamos
San Antonio, Texas

Figure No.
1